

**Project:** Springfield City Hall Renovation (2021)  
**Title:** Addendum No. 01  
**Date:** October 18, 2023  
**From:** PIVOT Architecture  
**To:** Interested Bidders



1. Response to Bidder Questions

- 1.1. **Q.** Do we have a Feeder Schedule for the one-line diagram on E621? Looks like we are providing a 225A new panel PLA and attaching it to an existing 100A breaker in SBE. Are we sizing the conduit and feeder for 100A or 225A? If we are sizing it for 100A can we reuse the existing conduit and feeders feeding PLA's old location, set a j-box and extend it to the new location. I'm pretty sure it's an overhead feed to the old location. If we are sizing it for 225A, I need the conduit and feeder requirements along with length of path back to SBE.  
**A.** Panelboard will be 100A per addendum 01 with feeder size provided in addendum.
- 1.2. **Q.** Can you confirm the water heater requirements? There is a conflict between Plumbing Eq. schedule and our Electrical Eq. Schedule. What is the size of the power to the hot water tank?  
**A.** See Addendum 01 drawing changes to reflect load increase.
- 1.3. **Q.** Like to confirm Access Control will be owner furnished, owner installed.  
**A.** Card readers will be owner furnished, owner installed items. These will be standalone battery powered units with no need for power.
- 1.4. **Q.** Bid doc 26 0500 3.07 says to provide extra stock as described in individual sections but I don't see any other reference of it in section 26. Will you be requiring any extra stock for Division 26?  
**A.** No extra stock is required for Div 26.
- 1.5. **Q.** Do you have any indication the number of days in the schedule for this project will be increased or left at 80 days?  
**A.** Schedule for the project increased to 120 calendar days. See revised documents.
- 1.6. **Q.** The following reference material for Div 27 is not included in the Bid Book, only the 4 pages of 27 1500 are included, can these sections be made available?  
**A.** Delete 1.05 and 1.06 from project manual. General quality assurance requirements for Div 26 are to be applied to Div 27.

- 1.7. **Q.** There was a reference to the Insurance requirements on Pg 18 that states those requirements could be found in 00170.70 of the Specs but this section was not included. What are the insurance requirements for this project?  
**A.** The page is from the City's Standard Contract that references their Standard Specifications. Those can be found at:  
<https://springfield-or.gov/wp-content/uploads/2022/07/2021-CertifiedLPAGeneralCondition-Eugene-Springfield-Edits-for-Website-Clean.pdf>
- 1.8. **Q.** There was no mention in the 4 pages of Div 27 as to the Current Data Rack being able to support the additional cabling or if Patch Panels were to be provided by the Div 27 Sub?  
**A.** Rack mounted equipment provided by the owner.
- 1.9. **Q.** Does the city want to/need to salvage any of the green carpet squares for surplus or for other offices?  
**A.** Contractor shall salvage carpet tiles to fill in and repair areas impacted by construction. No need to retain carpet tiles for attic stock.
- 1.10. **Q.** Will the card readers be installed by the city? Do they need separate power?  
**A.** Card readers will be owner furnished, owner installed items. These will be standalone battery powered units with no need for power.
- 1.11. **Q.** Is there fireproofing under City Hall or is that insulation?  
**A.** Plans and spec's do not show fireproofing on the underside of City Hall, This is insulation applied in the mid 80's as part of an energy efficiency project.
- 1.12. **Q.** What kind of parking is for the contractors to use? Is there a mobilization site?  
**A.** There is space under City Hall for contractor vehicles and staging. These areas are between the parking lots and sidewalks on both the north and south sides of A Street under City Hall. The parking lots and city streets are controlled, and tickets cannot be waived. Staff should park on or north of C Street where parking is not patrolled.

## 2. Changes to the Drawings

- 2.1. E121 – FLOOR PLAN - CM OFFICE dated 06.22.2023
- 2.1.1. (Reissued) – Revised break room circuits at kitchenette to be fed from panel FAA.
- 2.1.2. (Reissued) – Identified location of panel FAA.
- 2.2. E601 – SCHEDULES dated 06.22.2023
- 2.2.1. (Reissued) – Revised panel details and circuiting on panel PLA.
- 2.2.2. (Reissued) – Revised mechanical equipment details and circuits on Mechanical Equipment Connection Schedule.
- 2.3. E602 – SCHEDULES dated 06.22.2023
- 2.3.1. Issued sheet E602 to provide panel schedule for panel FAA.

2.4. E621 – WIRING DIAGRAMS dated 06.22.2023

2.4.1. (Reissued) – Revised panel PLA size to 100A from 225A

2.4.2. (Reissued) – Added feeder schedule.

3. Attachments


E121 - FLOOR PLAN - CM OFFICE

E601 - SCHEDULES

E602 - SCHEDULES


E621 - WIRING DIAGRAMS

End of Addendum # 01

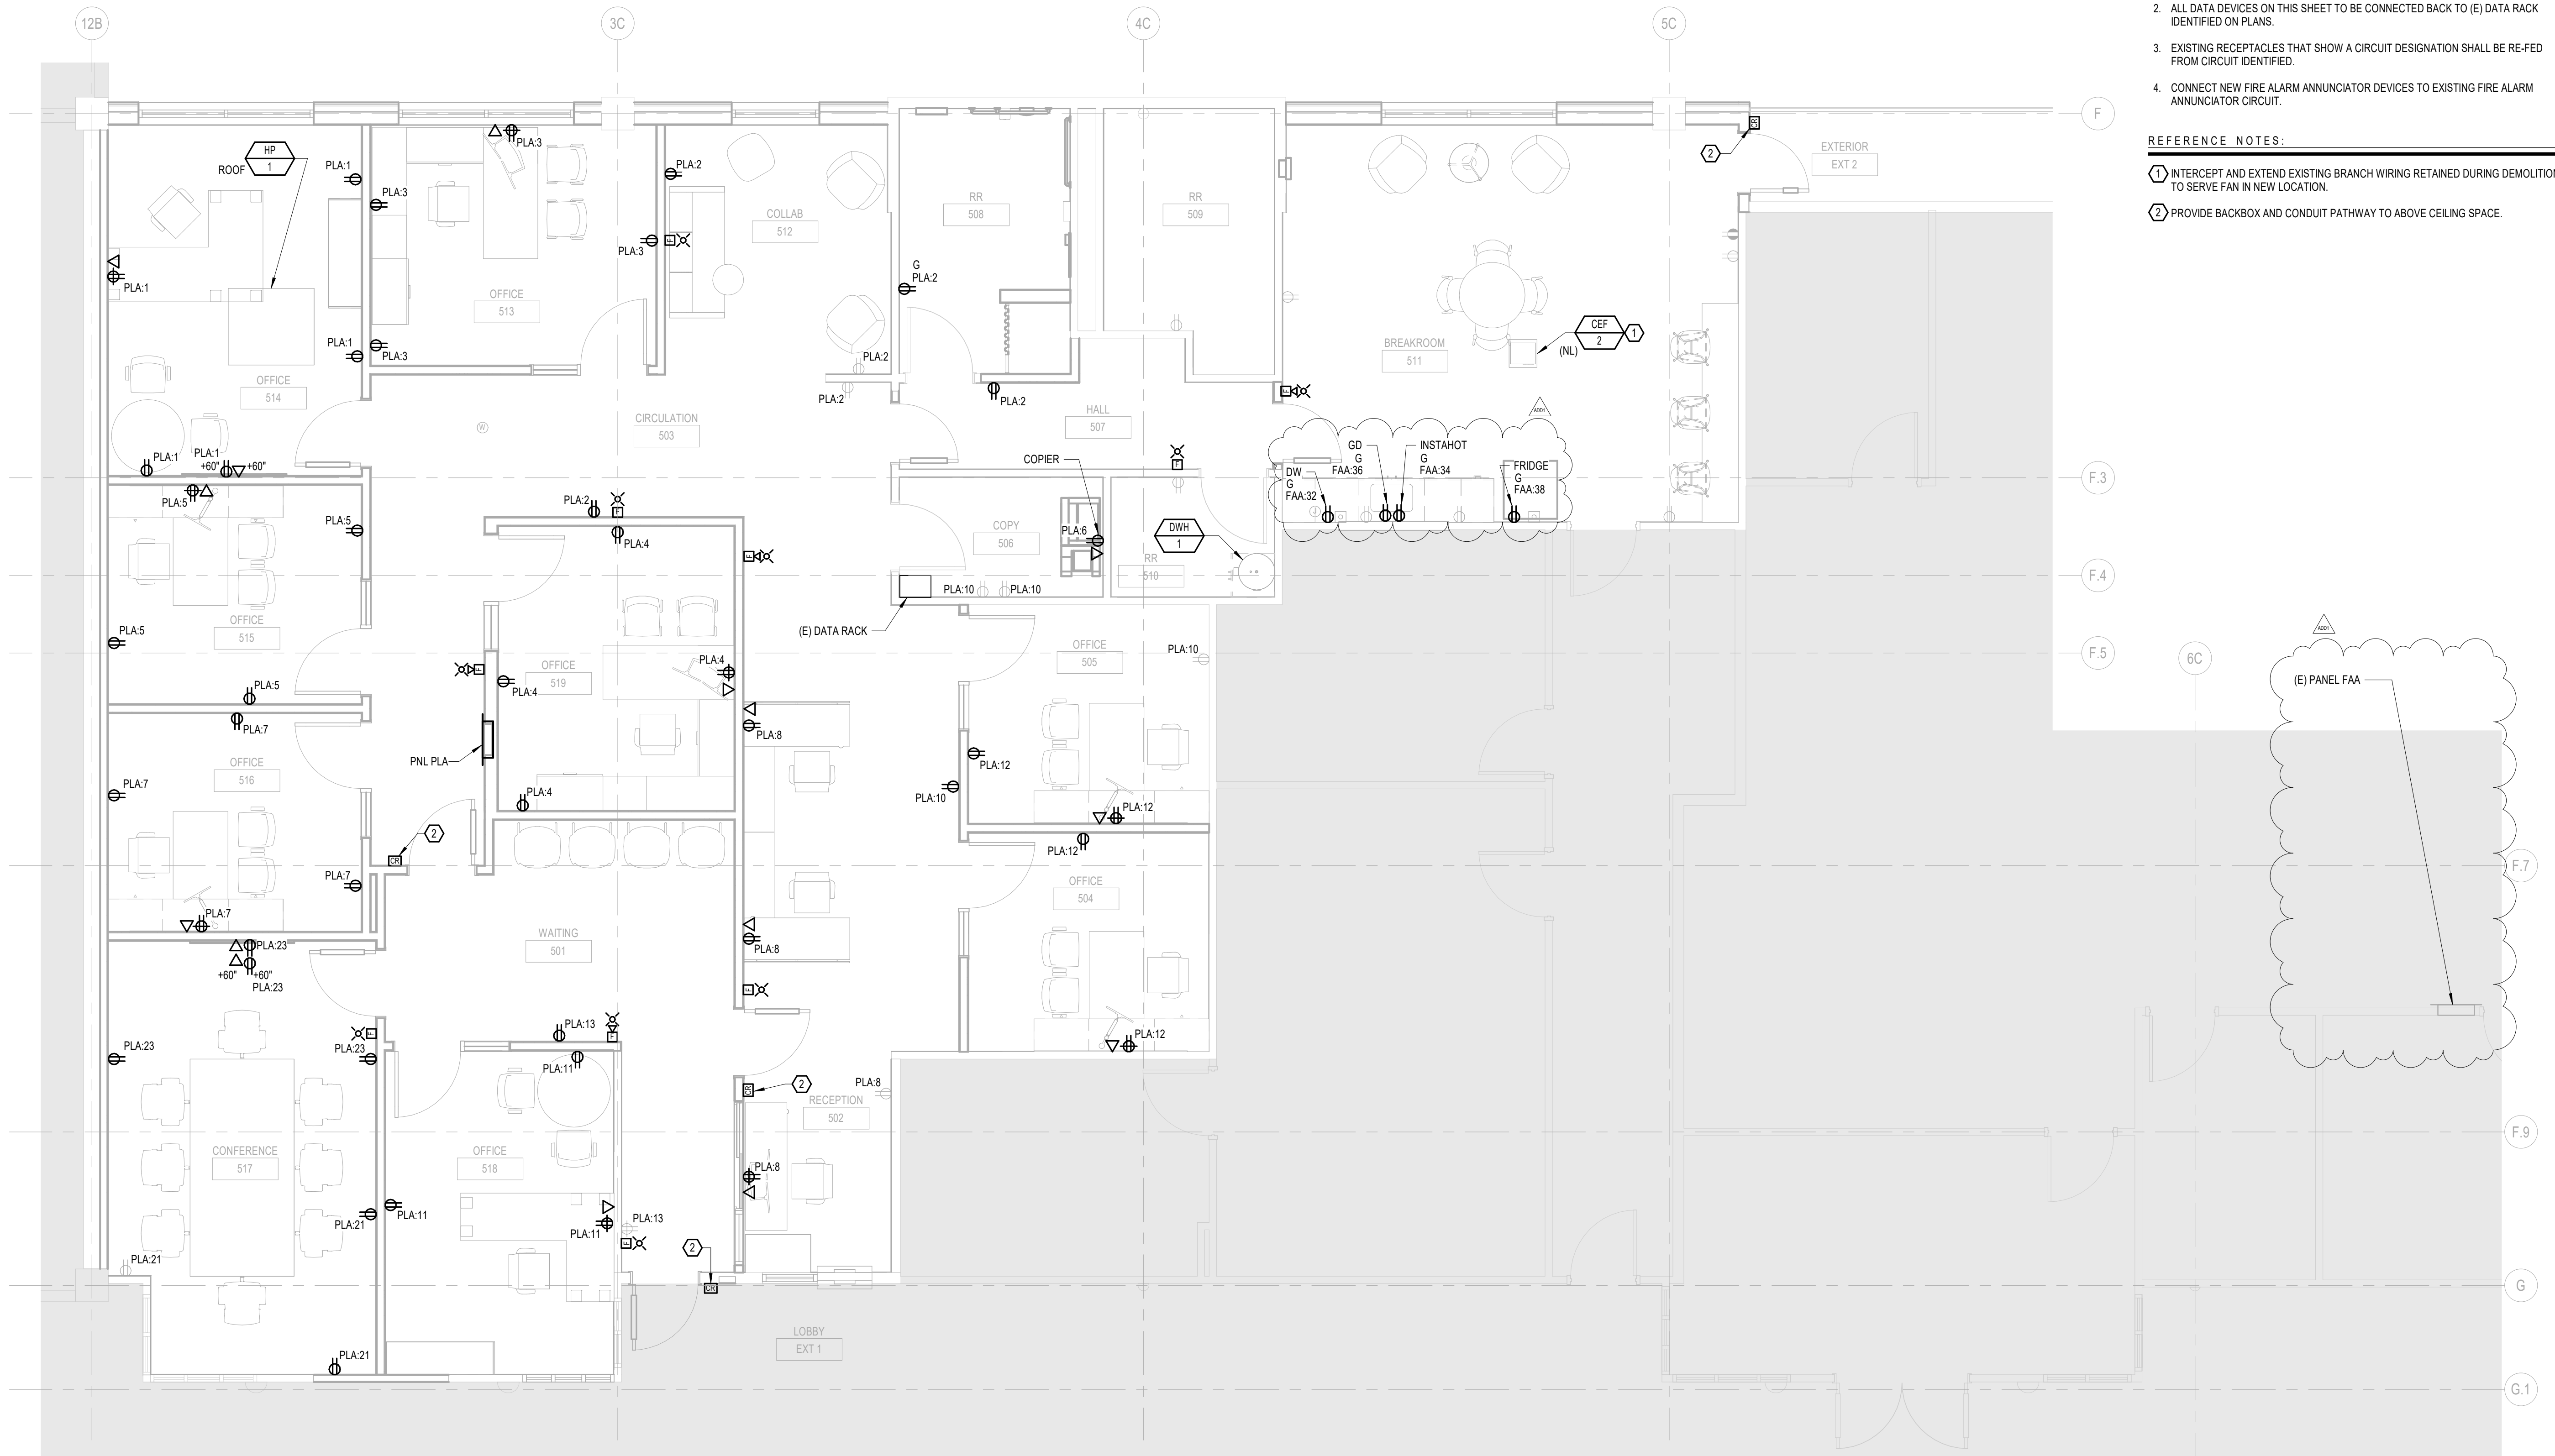

- SHEET NOTES:**
1. INFORMATION PRESENTED ON DRAWINGS IS BASED ON LIMITED SITE VISIT OBSERVATIONS AND AS-BUILT DRAWINGS. CONTRACTOR SHALL VERIFY ACTUAL CONDITIONS PRIOR TO COMMENCING WORK.
  2. ALL DATA DEVICES ON THIS SHEET TO BE CONNECTED BACK TO (E) DATA RACK IDENTIFIED ON PLANS.
  3. EXISTING RECEPTACLES THAT SHOW A CIRCUIT DESIGNATION SHALL BE RE-FED FROM CIRCUIT IDENTIFIED.
  4. CONNECT NEW FIRE ALARM ANNUNCIATOR DEVICES TO EXISTING FIRE ALARM ANNUNCIATOR CIRCUIT.
- REFERENCE NOTES:**
- 1 INTERCEPT AND EXTEND EXISTING BRANCH WIRING RETAINED DURING DEMOLITION TO SERVE FAN IN NEW LOCATION.
  - 2 PROVIDE BACKBOX AND CONDUIT PATHWAY TO ABOVE CEILING SPACE.

**1 FLOOR PLAN - CM OFFICE**  
1/4" = 1'-0"

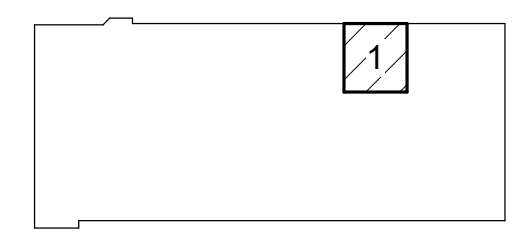

KEYPLAN



REVISIONS:

#	DESCRIP.	DATE
2	ADD1	06/22/2023

### LUMINAIRE SCHEDULE -

TYPE	DESCRIPTION	BOD MANUFACTURER	LAMP	ADDITIONAL SPECIFICATIONS AND NOTES
A1	2 FT X 4 FT LED LUMINOUS PANEL ASSEMBLY	LITHONIA EPANL SERIES LED LITHONIA 2BLT4 SERIES LED  OR APPROVED EQUIVALENT	LIGHT SOURCE: LED COLOR TEMP: 3500K CRI: 80+ OUTPUT: 4000 LM INPUT POWER: 38 W VOLTAGE: 120V	MOUNTING: RECESSED GRID HOUSING: ALUMINUM LENS/REFLECTOR: SATIN WHITE LENS DRIVER: 10% DIMMING DRIVER (0-10VDC) MISC:
A2	1 FT X 4 FT LED LUMINOUS PANEL ASSEMBLY	LITHONIA EPANL SERIES LED LITHONIA BLT4 SERIES LED  OR APPROVED EQUIVALENT	LIGHT SOURCE: LED COLOR TEMP: 3500K CRI: 80+ OUTPUT: 3000 LM INPUT POWER: 27 W VOLTAGE: 120V	MOUNTING: RECESSED GRID HOUSING: ALUMINUM LENS/REFLECTOR: SATIN WHITE LENS DRIVER: 10% DIMMING DRIVER (0-10VDC) MISC:
D4	4(DIA) X 6.6. INCH RECESSED LED DOWNLIGHT	GOTHAM EVO4SH SERIES  OR APPROVED EQUIVALENT	LIGHT SOURCE: LED COLOR TEMP: 3500K CRI: 80+ OUTPUT: 1000LM INPUT POWER: 9W VOLTAGE: 120V	MOUNTING: RECESSED HOUSING: 20G GALV. STEEL LENS/REFLECTOR: MED WIDE DISTRIBUTION, CLEAR, SEMI-SPECULAR DRIVER: 10% DIMMING DRIVER (0-10VDC) MISC: SELF-FLANGED
F(X)	5 IN X 4 IN X (X) FT DIRECT/INDIRECT PENDANT MOUNTED LED LUMINAIRE	AXIS LIGHTING BEAM6 DIRECT/INDIRECT SERIES  OR APPROVED EQUIVALENT	LIGHT SOURCE: LED COLOR TEMP: 3500K CRI: 90+ OUTPUT (UP): 400 LM/FT MIN OUTPUT (DOWN): 400 LM/FT MIN INPUT POWER: 3.1 W/FT VOLTAGE: 120 V	MOUNTING: PENDANT MOUNT HOUSING: EXTRUDED ALUMINUM LENS/REFLECTOR: FLUSH SPOTLESS FROSTED ACRYLIC DRIVER: 1% DIMMING DRIVER (0-10VDC) MISC:
X	12 X 7 X 4 INCH CAST ALUMINUM SURFACE MOUNT EXIT SIGN WITH GREEN LETTERS, UNIVERSAL MOUNTING KIT	LITHONIA LE SERIES  OR APPROVED EQUIVALENT	LIGHT SOURCE: LED COLOR TEMP: 3500K CRI: N/A OUTPUT: N/A INPUT POWER: 1W VOLTAGE: UNV	MOUNTING: UNIVERSAL MOUNT HOUSING: CAST ALUMINUM LENS/REFLECTOR: RED DRIVER: N/A MISC:

SCHEDULE GENERAL NOTES:  
1. (XX) DESIGNATES LENGTH OF FIXTURE IN FEET AS INDICATED ON THE DRAWING

### OCCUPANCY SENSOR SCHEDULE

TYPE	MODEL	TECHNOLOGY	MOUNTING	POWER PACK
A	nCM PDT 9 RJB	360° PASSIVE INFRARED, MICROPHONIC	CEILING	REQUIRED
B	SENSORSWITCH CM PDT 9 RJB	360° PASSIVE DUAL-TECH	CEILING	REQUIRED

SCHEDULE GENERAL NOTES:  
1. REFER TO LIGHTING PLANS FOR OCCUPANCY SENSOR LOCATIONS.  
2. BASIS OF DESIGN: ACUTY nLIGHT.

### MECHANICAL EQUIPMENT CONNECTION SCHEDULE

TAG	DESCRIPTION	VOLTAGE	PHASE	HP	KW	FLA	FEEDER DESCRIPTION	CIRCUIT BREAKER (AMPS/POLES)	PANEL IDENTIFICATION	STARTER DIVISION	DISCONNECT DIVISION	VFD DIVISION	NOTES
DWH-1	DOMESTIC WATER HEATER	208	3		15	41.6	(3) 6 AWG CU, (1) 10 AWG GND. IN 1" C.	60/3	PLA-14,16,18	NA	DIV 26	NA	
HP-1	ROOFTOP HEAT PUMP	208	1		4	19.2	(3) 10 AWG CU, (1) 10 AWG GND. IN 3/4" C.	30/2	PLA-20,22	NA	DIV 26	NA	

### PANEL SCHEDULE

PANEL: PLA  
VOLTS: 120/208  
LOCATION: CIRCULATION 503  
MOUNTING: RECESSED

TYPE	BOLT ON	AMPS	100
PHASE	3	WIRE	4
MAIN	MLO	AFC	
LOAD CLASS	CONN. VA	DEMAND FACTOR	DEMAND LOAD VA
LIGHTING	1420	125%	1775
RECEPTACLES	11820	*	10910
MOTOR LOADS	4000	**	5000
RESISTANCE LOADS	15000	100%	15000
SUBFEED	0	100%	0
MISC. LOADS	0	100%	0
SUBFEED BREAKER	0		0
		CONNECTED	DEMAND
TOTAL VOLT-AMPS		32,240	32,685
MAXIMUM PHASE AMPS		94.3	96.7

BREAKER A	P	DESCRIPTION	WATTS	CIR. NO.	PHASE	CIR. NO.	WATTS	DESCRIPTION	BREAKER P	A
20	1	RECEPT: OFFICE 514	900	1	A	2	720	RECEPT: COLLAB 512, CIRC 503, HALL 507	1	20
20	1	RECEPT: OFFICE 513	900	3	B	4	900	RECEPT: OFFICE 519	1	20
20	1	RECEPT: OFFICE 515	900	5	C	6	1200	RECEPT: OFFICE 506 COPIER	1	20
20	1	RECEPT: OFFICE 516	900	7	A	8	900	RECEPT: RECEPTION 502	1	20
20	1	LTG: EXIT SIGNS	100	9	B	10	720	RECEPT: OFFICE 504, 505	1	20
20	1	RECEPT: OFFICE 518	900	11	C	12	1080	RECEPT: OFFICE 505, COPY 506, 502	1	20
20	1	RECEPT: WAITING 501	540	13	A	14	5000	DWH-1	3	60
20	1	LTG: 501, 513, 514, 515, 516, 517, 518	600	15	B	16	5000			
20	1	LTG: 506, 519, 512, 508	360	17	C	18	5000			
20	1	LTG: OFFICE 504,505, BREAK 511	360	19	A	20	2000	HP-1	2	30
20	1	RECEPT: CONFERENCE 517	540	21	B	22	2000			
20	1	RECEPT: CONFERENCE 517	720	23	C	24		SPARE	1	20
20	1	SPARE		25	A	26		SPARE	1	20
20	1	SPARE		27	B	28		SPARE	1	20
20	1	SPARE		29	C	30		SPARE	1	20
20	1	SPARE		31	A	32		SPARE	1	20
20	1	SPARE		33	B	34		SPARE	1	20
20	1	SPARE		35	C	36		SPARE	1	20
20	1	SPARE		37	A	38		SPARE	1	20
20	1	SPARE		39	B	40		SPARE	1	20
20	1	SPARE		41	C	42		SPARE	1	20

PHASE TOTALS

	CONNECTED VA	A	B	C
CONNECTED VA	11320	10760	10160	
DEMAND VA	11605	11199	9880	
CONNECTED AMPS	94.3	89.7	84.7	
DEMAND AMPS	96.7	93.3	82.3	

\* 10KVA AT 100%, REMAINDER AT 50%  
\*\* 100% PLUS 25% OF THE LARGEST MOTOR

### PANEL SCHEDULE

PANEL: CMA  
VOLTS: 120/208  
LOCATION: HALL 412  
MOUNTING: RECESSED

TYPE	BOLT ON	AMPS	100
PHASE	1	WIRE	3
MAIN	MLO	AFC	
LOAD CLASS	CONN. VA	DEMAND FACTOR	DEMAND LOAD VA
LIGHTING	0	125%	0
RECEPTACLES	2700	*	2700
MOTOR LOADS	0	**	0
RESISTANCE LOADS	0	100%	0
SUBFEED	0	100%	0
MISC. LOADS	0	100%	0
SUBFEED BREAKER	0		0
		CONNECTED	DEMAND
TOTAL VOLT-AMPS		2,700	2,700
MAXIMUM PHASE AMPS		12.0	12.0

BREAKER A	P	DESCRIPTION	WATTS	CIR. NO.	PHASE	CIR. NO.	WATTS	DESCRIPTION	BREAKER P	A
20	1	(E) LOAD		1	A	2		(E) LOAD	1	20
20	1	(E) LOAD		3	B	4		(E) LOAD	1	20
20	1	(E) LOAD		5	A	6		(E) LOAD	1	20
20	1	(E) LOAD		7	B	8		(E) LOAD	1	20
15	1	(E) LOAD		9	A	10		(E) LOAD	1	20
15	1	(E) LOAD		11	B	12		(E) LOAD	1	20
20	2	(E) LOAD		13	A	14		(E) LOAD	1	20
				15	B	16		(E) LOAD	1	20
30	2	(E) LOAD		17	A	18		(E) LOAD	1	20
				19	B	20		(E) LOAD	1	20
20	1	(E) LOAD		21	A	22		(E) LOAD	1	20
20	1	(E) LOAD		23	B	24		(E) LOAD	1	20
20	1	(E) LOAD		25	A	26		(E) LOAD	1	20
20	1	(E) LOAD		27	B	28		(E) LOAD	1	20
20	1	(E) LOAD		29	A	30		(E) LOAD	1	20
20	1	RECEPT: MEETING 316,317,318	720	31	B	32	540	RECEPT: MEETING 316,317,318	1	20
20	1	RECEPT: CIRCULATION DESK 301A	720	33	A	34	720	RECEPT: CIRCULATION DESK 310A	1	20
20	1			35	B	36			1	20
20	1			37	A	38			1	20
20	1			39	B	40			1	20
20	1			41	A	42			1	20

PHASE TOTALS

	CONNECTED VA	A	B
CONNECTED VA	1440	1260	
DEMAND VA	1440	1260	
CONNECTED AMPS	12.0	10.5	
DEMAND AMPS	12.0	10.5	

\* 10KVA AT 100%, REMAINDER AT 50%  
\*\* 100% PLUS 25% OF THE LARGEST MOTOR



**SYSTEMS WEST ENGINEERS**  
725 A Street  
Springfield, OR 97477  
541.342.7210  
systemswestengineers.com  
SWE Project # 2005.01


CONSTRUCTION DRAWINGS  
SPRINGFIELD CITY HALL RENOVATION  
PROJECT #: 2125.00  
CITY OF SPRINGFIELD  
225 5TH ST, SPRINGFIELD, OR 97477

SHEET TITLE:  
**SCHEDULES**

REVISIONS:  
# DESCRP. DATE  
2 ADD1 06/22/2023

ISSUE DATE: 04.10.2023

PANEL SCHEDULE										
PANEL: FAA		TYPE: BOLT ON		AMPS: 225						
VOLTS: 120/240		PHASE: 1		WIRE: 3						
LOCATION: FIRE ADMIN		MAIN: MLO		AFC:						
MOUNTING: RECESSED										
NOTES: THIS IS AN EXISTING PANEL. NEW LOADS SHOWN IN BOLD, PROVIDE NEW BREAKERS FOR NEW BRANCH CIRCUITS AS SHOWN.										
		LOAD CLASS		CONN. VA		DEMAND FACTOR		DEMAND LOAD VA		
		LIGHTING		0		125%		0		
		RECEPTACLES		3750		*		3750		
		MOTOR LOADS		0		**		0		
		RESISTANCE LOADS		0		100%		0		
		SUBFEED		0		100%		0		
		MISC. LOADS		0		100%		0		
		SUBFEED BREAKER		0				0		
						CONNECTED		DEMAND		
						TOTAL VOLT-AMPS		3,750		
						MAXIMUM PHASE AMPS		16.3		
BREAKER A	P	DESCRIPTION	WATTS	CIR. NO.	PHASE	CIR. NO.	WATTS	DESCRIPTION	BREAKER P	A
20	1	(E) LOAD	0	1	A	2	0	(E) LOAD	1	20
20	1	(E) LOAD	0	3	B	4	0	(E) LOAD	1	20
20	1	(E) LOAD	0	5	A	6	0	(E) LOAD	1	20
20	1	(E) LOAD	0	7	B	8	0	(E) LOAD	1	20
20	1	(E) LOAD	0	9	A	10	0	(E) LOAD	1	20
20	1	(E) LOAD	0	11	B	12	0	(E) LOAD	1	20
20	1	(E) LOAD	0	13	A	14	0	(E) LOAD	1	20
20	1	(E) LOAD	0	15	B	16	0	(E) LOAD	1	20
20	1	(E) LOAD	0	17	A	18	0	(E) LOAD	1	20
20	1	(E) LOAD	0	19	B	20	0	(E) LOAD	1	20
20	1	(E) LOAD	0	21	A	22	0	(E) LOAD	1	20
30	2	(E) LOAD	0	23	B	24	0	(E) LOAD	1	20
			0	25	A	26	0	(E) LOAD	1	20
20	1	(E) LOAD	0	27	B	28	0	(E) LOAD	1	20
20	1	(E) LOAD	0	29	A	30	0	(E) LOAD	1	20
20	1	(E) SPARE	0	31	B	32	750	RECEPT: BREAK 511 INSTAHOT	1	20
20	1	(E) SPARE	0	33	A	34	600	RECEPT: BREAK 511 FRIDGE	1	20
20	1	(E) LOAD	0	35	B	36	1200	RECEPT: BREAK 511 GARBAGE DISPOSAL	1	20
20	1	(E) LOAD	0	37	A	38	1200	RECEPT: BREAK 511 DISHWASHER	1	20
20	1	(E) SPARE	0	39	B	40	0	(E) SPACE		
20	1	(E) LOAD	0	41	A	42	0	(E) SPACE		
PHASE TOTALS				CONNECTED VA	1800	1950				
				DEMAND VA	1800	1950				
				CONNECTED AMPS	15.0	16.3				
				DEMAND AMPS	15.0	16.3				
				A	1800	1950	* 10KVA AT 100%, REMAINDER AT 50%			
				B	1800	1950	** 100% PLUS 25% OF THE LARGEST MOTOR			

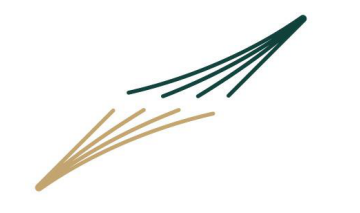

**SYSTEMS WEST ENGINEERS**  
725 A Street  
Springfield, OR 97477  
541.342.7210  
systemswestengineers.com  
SWE Project # Z005.01

CONSTRUCTION DRAWINGS  
**SPRINGFIELD CITY HALL RENOVATION**  
PROJECT #: 2125.00  
CITY OF SPRINGFIELD  
225 5TH ST, SPRINGFIELD, OR 97477

SHEET TITLE:  
**SCHEDULES**

REVISIONS:	#	DESCRP.	DATE
	2	ADD1	06/22/2023

ISSUE DATE: 06/21/23

**E602**

FEEDER SCHEDULE COPPER, 3-PHASE, 3-WIRE PLUS GROUND							
FEEDER TAG	NOMINAL RATING (A)	CONDUIT		PHASE CONDUCTORS		GROUND CONDUCTORS	
		TOTAL QTY	NOMINAL DIAMETER (INCHES)	TOTAL QTY	AWG OR KCMIL	TOTAL QTY	AWG OR KCMIL
20A	20	1	0.75	3	12	1	12
25A	25	1	0.75	3	10	1	10
30A	30	1	0.75	3	10	1	10
35A	35	1	1	3	8	1	10
40A	40	1	1	3	8	1	10
50A	50	1	1	3	6	1	10
60A	60	1	1	3	6	1	10
70A	70	1	1	3	4	1	8
80A	80	1	1.25	3	3	1	8
90A	90	1	1.25	3	3	1	8
100A	100	1	1.25	3	3	1	8
110A	110	1	1.5	3	2	1	8
125A	125	1	1.5	3	1	1	6
150A	150	1	1.5	3	1/0	1	6
175A	175	1	2	3	2/0	1	6
200A	200	1	2	3	3/0	1	6
225A	225	1	2	3	4/0	1	4
250A	250	1	2.5	3	250	1	4
300A	300	1	3	3	350	1	4
350A	350	1	3	3	400	1	3
400A	400	2	2.5	6	3/0	2	3
450A	450	2	2.5	6	4/0	2	2
500A	500	2	3	6	250	2	2
600A	600	2	3	6	350	2	1
800A	800	3	3	9	300	3	1/0
1000A	1000	3	3.5	9	400	3	2/0
1200A	1200	4	3	12	350	4	3/0
1600A	1600	5	3.5	15	400	5	4/0
2000A	2000	6	3.5	18	400	6	250
2500A	2500	7	3.5	21	500	7	350
3000A	3000	8	3.5	24	500	8	400

FEEDER SCHEDULE COPPER, 3-PHASE, 4-WIRE PLUS GROUND							
FEEDER TAG	NOMINAL RATING (A)	CONDUIT		PHASE & NEUTRAL CONDUCTORS		GROUND CONDUCTORS	
		TOTAL QTY	NOMINAL DIAMETER (INCHES)	TOTAL QTY	AWG OR KCMIL	TOTAL QTY	AWG OR KCMIL
20B	20	1	0.75	4	12	1	12
25B	25	1	0.75	4	10	1	10
30B	30	1	0.75	4	10	1	10
35B	35	1	1	4	8	1	10
40B	40	1	1	4	8	1	10
50B	50	1	1.25	4	6	1	8
60B	60	1	1.25	4	6	1	8
70B	70	1	1.25	4	4	1	8
80B	80	1	1.25	4	3	1	8
90B	90	1	1.5	4	3	1	8
100B	100	1	1.5	4	3	1	8
110B	110	1	1.5	4	2	1	6
125B	125	1	1.5	4	1	1	6
150B	150	1	2	4	1/0	1	6
175B	175	1	2	4	2/0	1	6
200B	200	1	2.5	4	3/0	1	6
225B	225	1	2.5	4	4/0	1	4
250B	250	1	3	4	250	1	4
300B	300	1	3.5	4	350	1	2
350B	350	1	3.5	4	500	1	1
400B	400	2	2.5	8	3/0	2	2
450B	450	2	2.5	8	4/0	2	2
500B	500	2	3	8	250	2	1
600B	600	2	3.5	8	350	2	1
800B	800	3	3.5	12	300	3	1/0
1000B	1000	3	4	12	500	3	2/0
1200B	1200	4	4	16	400	4	3/0
1600B	1600	5	4	20	500	5	4/0
2000B	2000	6	4	24	500	6	250
2500B	2500	8	4	32	500	8	350
3000B	3000	9	4	36	500	9	400

DETAIL GENERAL NOTES:


1. INFORMATION PRESENTED ON DRAWINGS IS BASED ON LIMITED SITE VISIT OBSERVATIONS AND AS-BUILT DRAWINGS. CONTRACTOR SHALL VERIFY ACTUAL CONDITIONS PRIOR TO COMMENCING WORK.

DETAIL REFERENCE NOTES:

- ① DEMOLISH EXISTING PANELBOARD 'PLA' AND FEEDERS. REFER TO 1/E101.
- ② PROVIDE NEW 42-CIRCUIT PANELBOARD IN NEW LOCATION. PROVIDE NEW FEEDERS AS INDICATED AND SERVE PANELBOARD FROM EXISTING SPARE BREAKER IN SWITCHBOARD 'SBE'. REFER TO 1/E121 AND PANEL SCHEDULES FOR ADDITIONAL INFORMATION.
- ③ REMOVE PANELBOARD 'CMA'. RETAIN FEEDERS & BRANCH CIRCUITS FOR RECONNECTION TO NEW PANELBOARD. PROVIDE NEW 42-CIRCUIT PANELBOARD IN PREVIOUS LOCATION. REFER TO 1/E122 AND PANEL SCHEDULE FOR ADDITIONAL INFORMATION.



**SYSTEMS WEST ENGINEERS**  
725 A Street  
Springfield, OR 97477  
541.342.7210  
systemswestengineers.com  
SWE Project # 2005.01

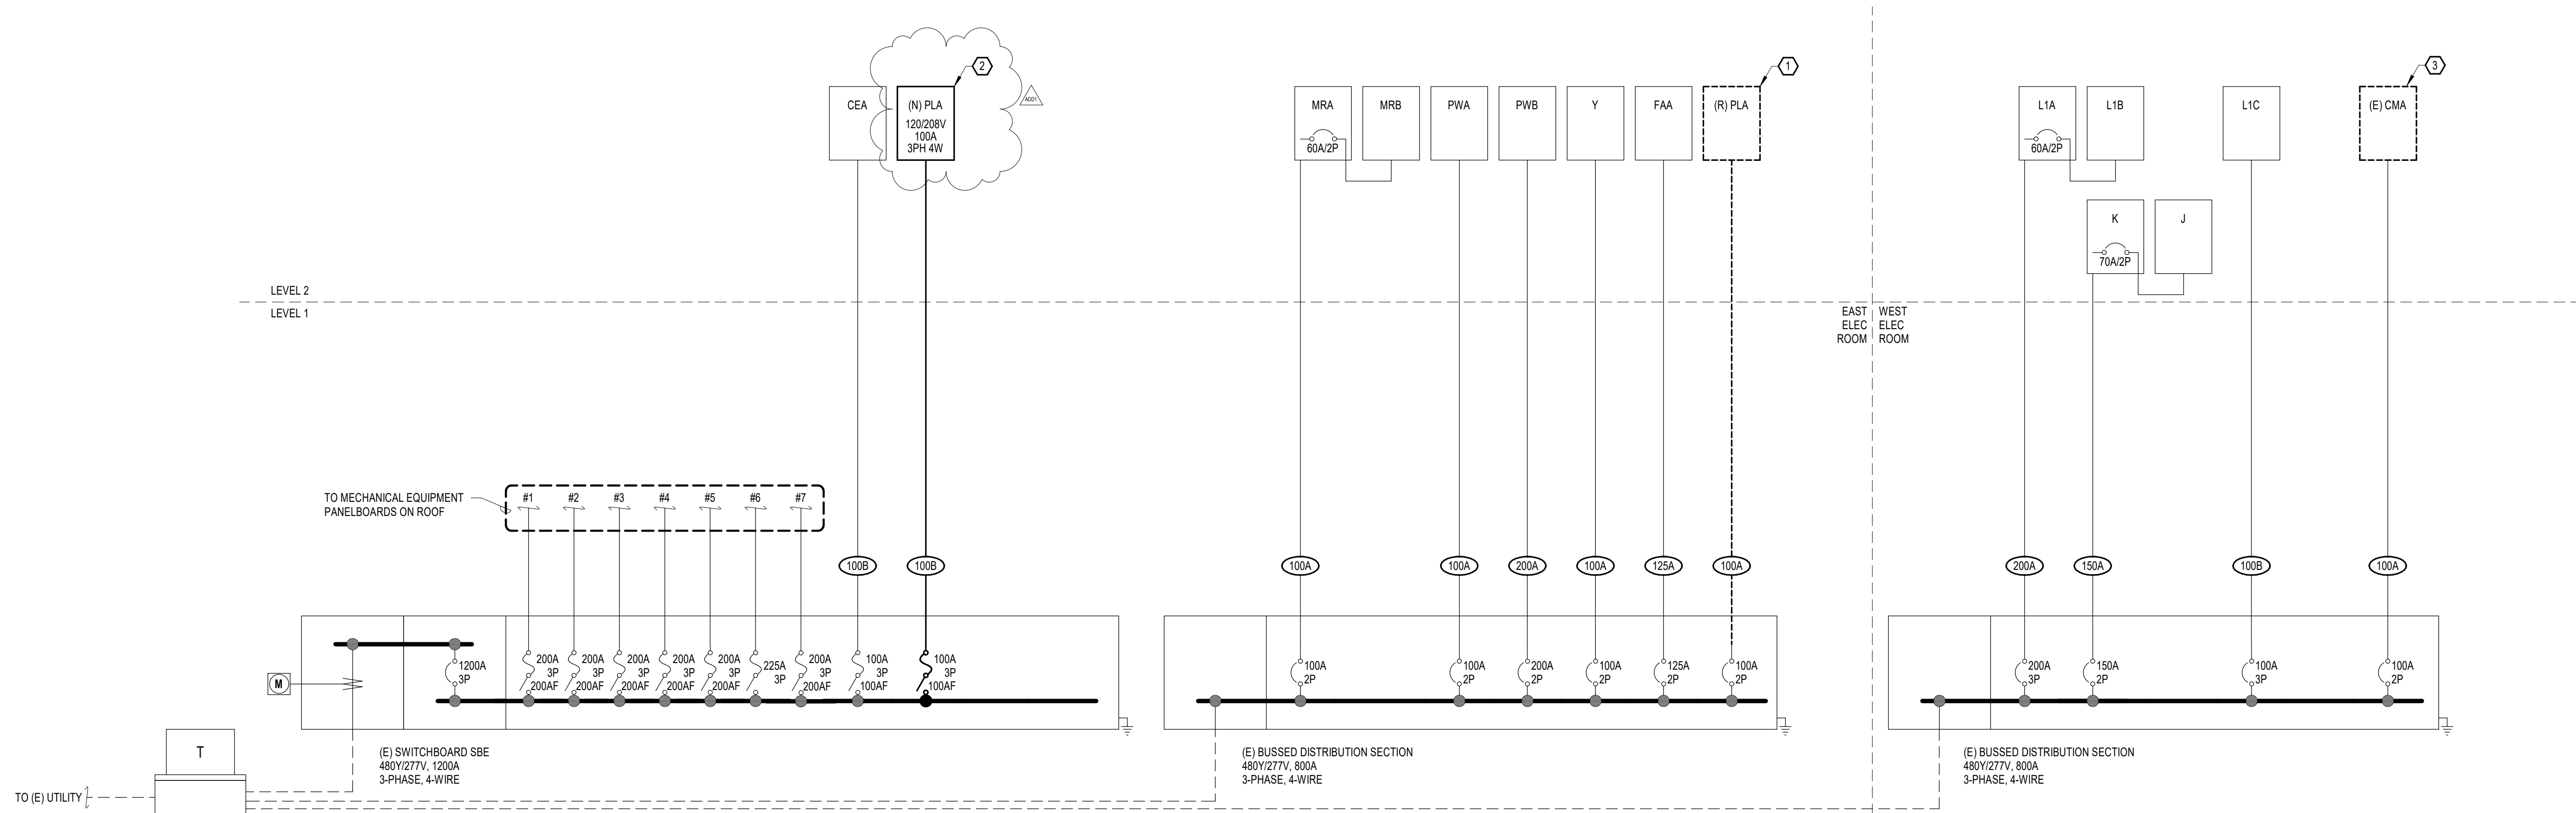

**1 ONE-LINE DIAGRAM**  
NOT TO SCALE

CONSTRUCTION DRAWINGS  
**SPRINGFIELD CITY HALL RENOVATION**  
PROJECT #: 2125.00  
CITY OF SPRINGFIELD  
225 5TH ST, SPRINGFIELD, OR 97477

SHEET TITLE:  
**WIRING DIAGRAMS**

REVISIONS:		
#	DESCRIP.	DATE
2	ADD1	06/22/2023

ISSUE DATE: 04.10.2023